

OA-125-1

RESOLUTION PETITIONING THE MUNICIPAL BOARD TO
ANNEX CERTAIN ADJOINING UNINCORPORATED TERRITORY
TO THE CITY OF GAYLORD

REC'D. BY
MMB SEP 14 1977

WHEREAS, certain territory described below is not presently included within the incorporated limits of any city, village, or borough; and

WHEREAS, this territory abuts upon the city limits at the east boundary thereof and is or is about to become urban or suburban in character, and

WHEREAS, the city has either provided municipal utilities to the area or has them available and is willing and capable of providing city services to the area;

BE IT RESOLVED BY THE CITY COUNCIL OF GAYLORD, MINNESOTA:

1. The City Council hereby determines (1) that annexation of the territory described in Section 2 will be to the best interests of the city and of the territory affected; (2) that the territory abuts upon the city limits and is or is about to become urban or suburban in character; (3) that none of said territory is now included within the limits of any city, village or borough and that the city has either provided municipal utilities to the area or has them available and is willing and capable of providing city services to the area.

2. The Council hereby declares its desire to annex the following territory to the city:

East Ridge Terrace, being a subdivision of part of Government Lot One (1) in Section Thirty-three (33), Township One Hundred Thirteen (113), Range Twenty-eight (28), Sibley County, Minnesota.

Also, that part of the Chicago and Northwestern Transportation Company's right of way lying between the northerly extension of the west line of said East Ridge Terrace, according to the recorded plat thereof, and the northerly extension of the east line of said East Ridge Terrace, according to the recorded plat thereof.

Excepting from the land described above two tracts previously annexed by the City of Gaylord, described as follows:

1. Lots Number Twenty-one, Twenty-two and Twenty-three (21, 22, & 23) in East Ridge Terrace, being a subdivision of part of Government Lot One (1) in Section Thirty-three (33), Township One Hundred Thirteen (113), Range Twenty-eight (28).

Also, that part of the Chicago and Northwestern Transportation Company's right of way lying between the northerly extension of the westerly line of Second Street East, East Ridge Terrace, according to the recorded plat thereof, and the northerly extension of the westerly line of Lot 9, East Ridge Terrace, according to the recorded plat thereof.

2. Lot Nine (9) in East Ridge Terrace, being a subdivision of part of Govt. Lot One (1) in Section Thirty-three (33), Township One Hundred Thirteen (113) Range Twenty-eight (28), including that portion of the road which abuts said lot on the north.

Adopted by the Council this 8th day of September, 1977.



Mayor




Clerk

REC'D. BY
MMB SEP 16 1977

OA-125-1

Chyflara

MAP OF THE
CITY OF GAYLORD
SIBLEY COUNTY MINNESOTA
ELEVATION ABOVE SEA LEVEL 1017.856 BASE OF WATERTOWER
SCALE

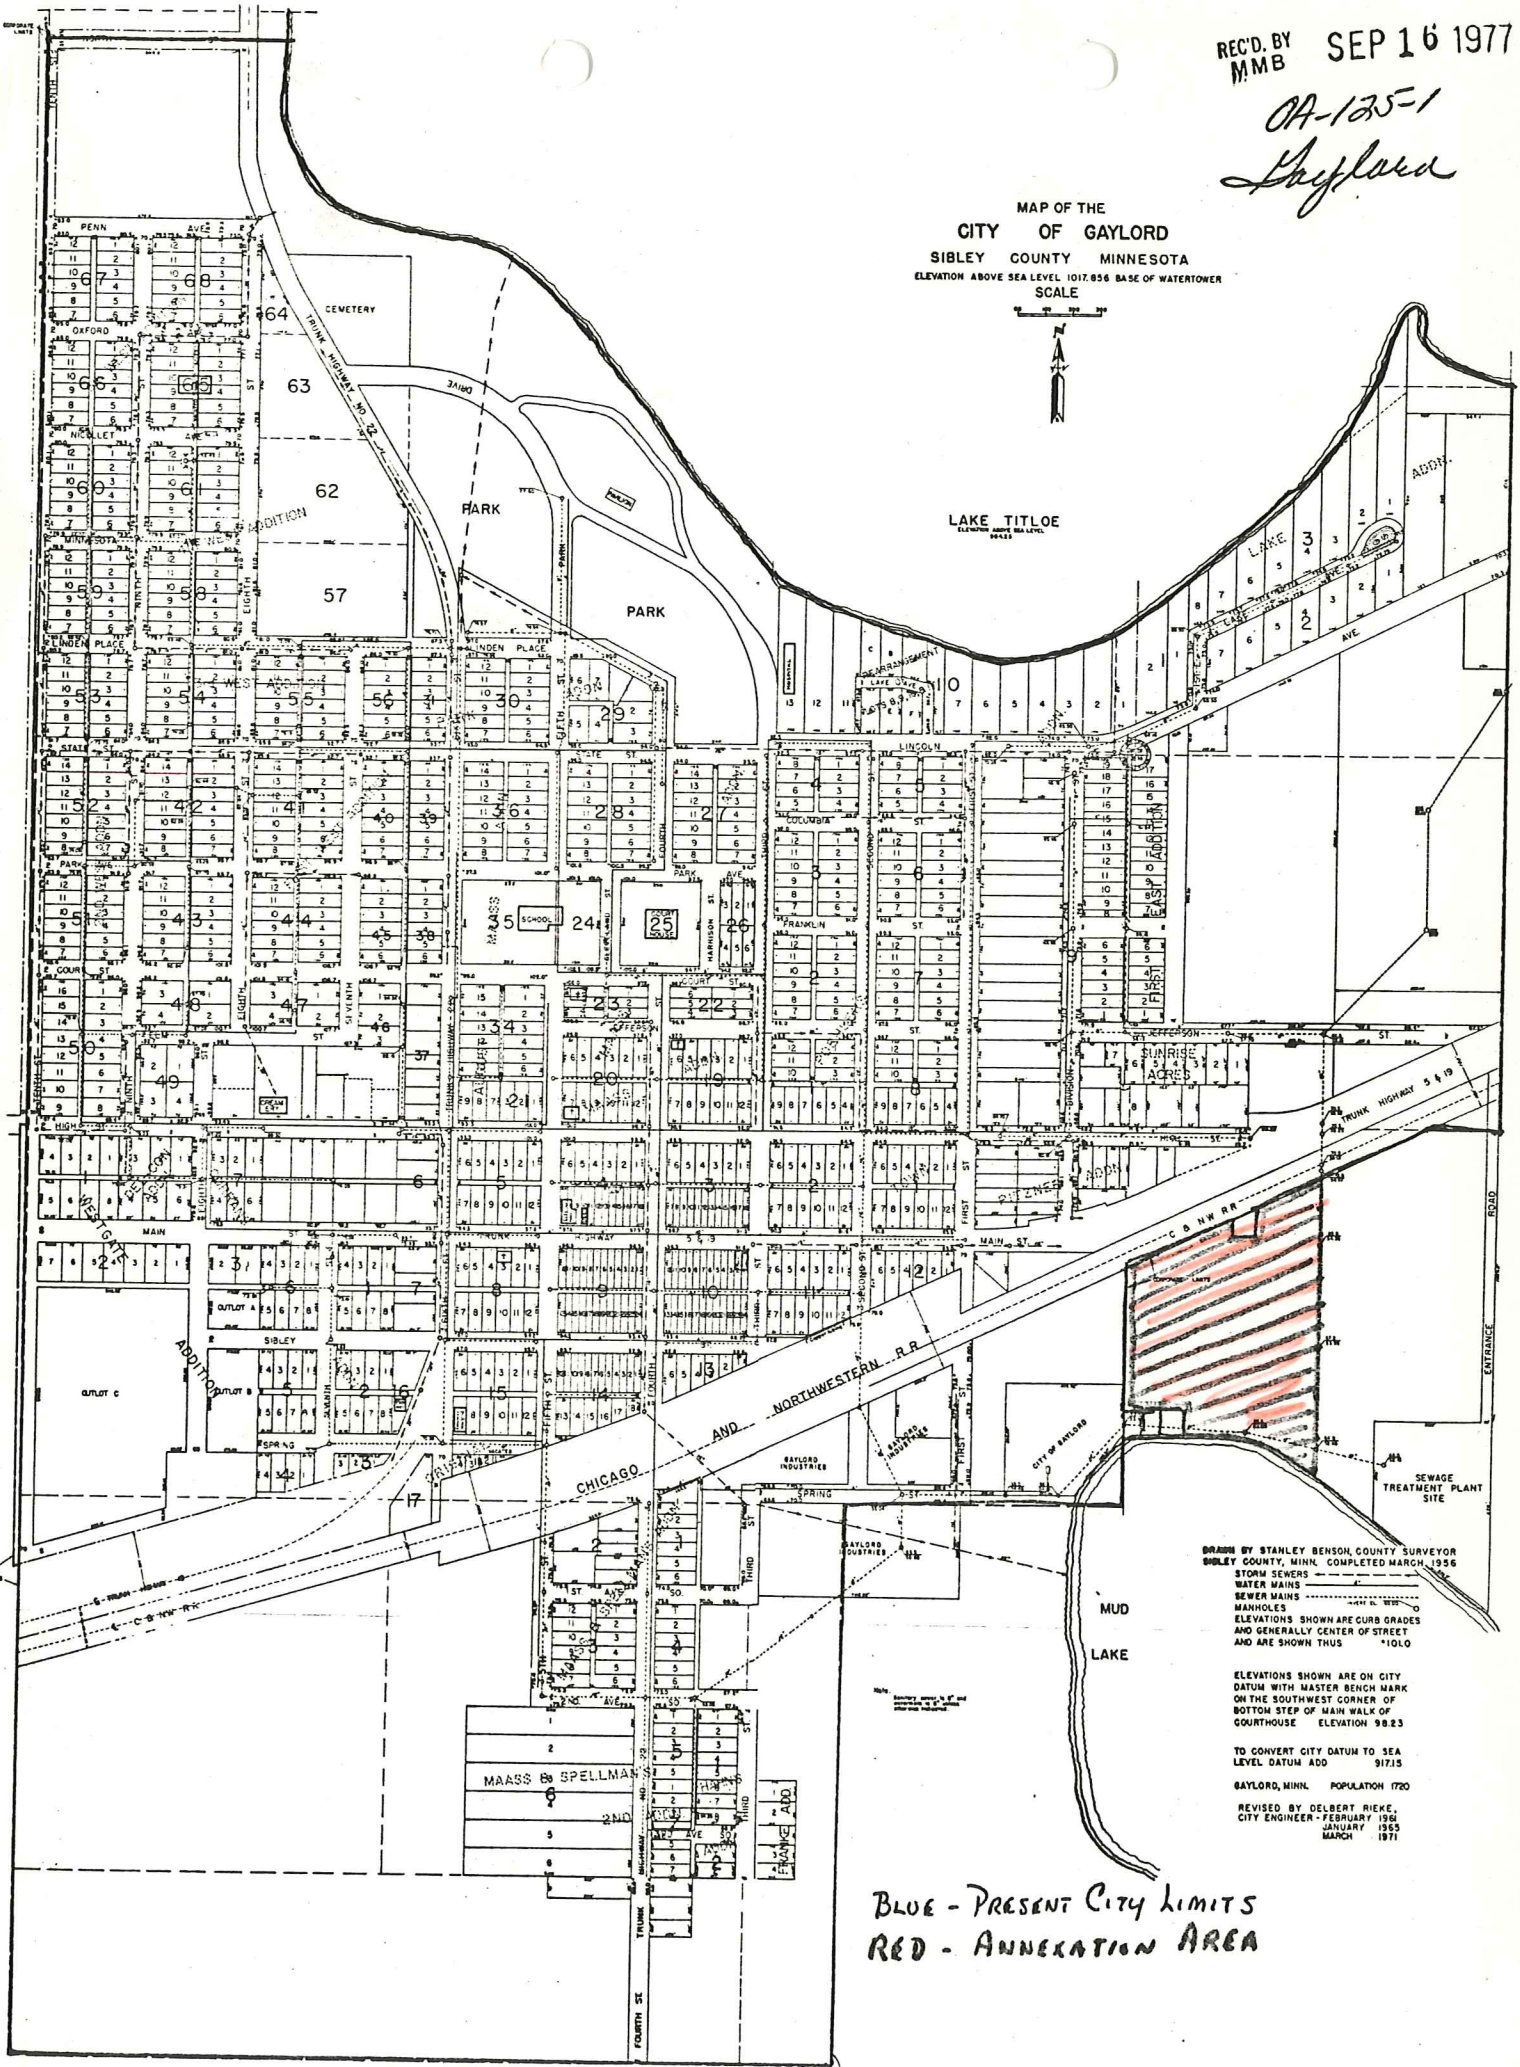

DRAWN BY STANLEY BENSON, COUNTY SURVEYOR
SIBLEY COUNTY, MINN. COMPLETED MARCH, 1956
STORM SEWERS
WATER MAINS
SEWER MAINS
MANHOLES
ELEVATIONS SHOWN ARE CURB GRADES
AND GENERALLY CENTER OF STREET
AND ARE SHOWN THUS "10.0"

ELEVATIONS SHOWN ARE ON CITY
DATUM WITH MASTER BENCH MARK
ON THE SOUTHWEST CORNER OF
BOTTOM STEP OF MAIN WALK OF
COURTHOUSE ELEVATION 98.83

TO CONVERT CITY DATUM TO SEA
LEVEL DATUM ADD 917.15

GAYLORD, MINN. POPULATION 1720
REVISED BY DELBERT RIEKE,
CITY ENGINEER - FEBRUARY 1966
JANUARY 1965
MARCH 1971

BLUE - PRESENT CITY LIMITS
RED - ANNEXATION AREA